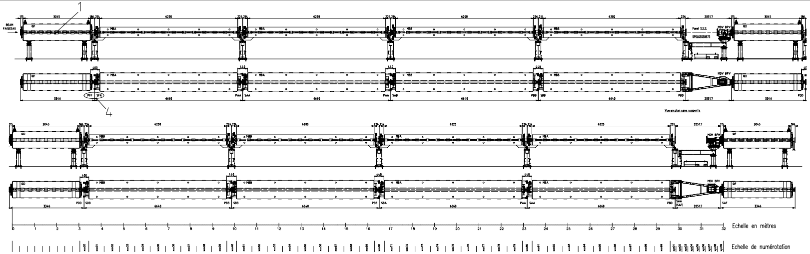

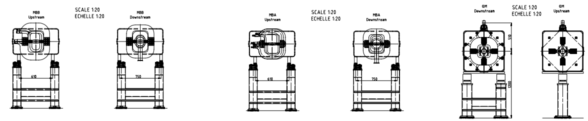

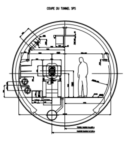

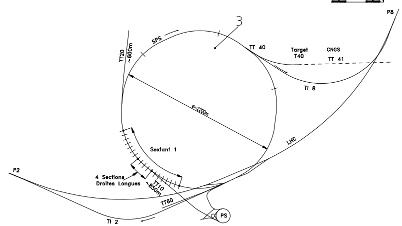

IND.	DATE	NOM/NAME	ZONE	MODIFICATION

QUANT.	DESCRIPTION	POS	MAT.	OBSERVATIONS	REF.CERN
1		7			
1		6			
1		5			
1	PUMPING PORT SHIELDING	4		SPSVSRFS0086	
1	SPS COMPLEX	3		SPSLM_____0001	
1		2			
1	LENS DIPOLE - LAYOUT ASSEMBLY PLAN DE MONTAGE - LENTILLE DIPOLE	1		SPS 8014-6100	

ENS/ASS | S.ENS/S.ASS

LAYOUT D'INSTALLATION MACHINES LEP-SPS

SPS - STANDARDS PERIODS PARMETERS
SPS - PERIODES STANDARDS PARAMETRES

ECHELLE SCALE 1:50

DES/DRA.	J.RAMILLON	2007-10-15
CONTROLLED	C.MICHAUD	2007-10-24
RELEASED	N.GILBERT	2007-10-24
APPROVED	-	-

SPS\LNINS0\LNINS050

REMPLACE/REPLACES

RELEASED BY PROJECT ENGINEER | AS BUILT | QAC - | SPSLNINS0050 | SIZE 1 | IND.