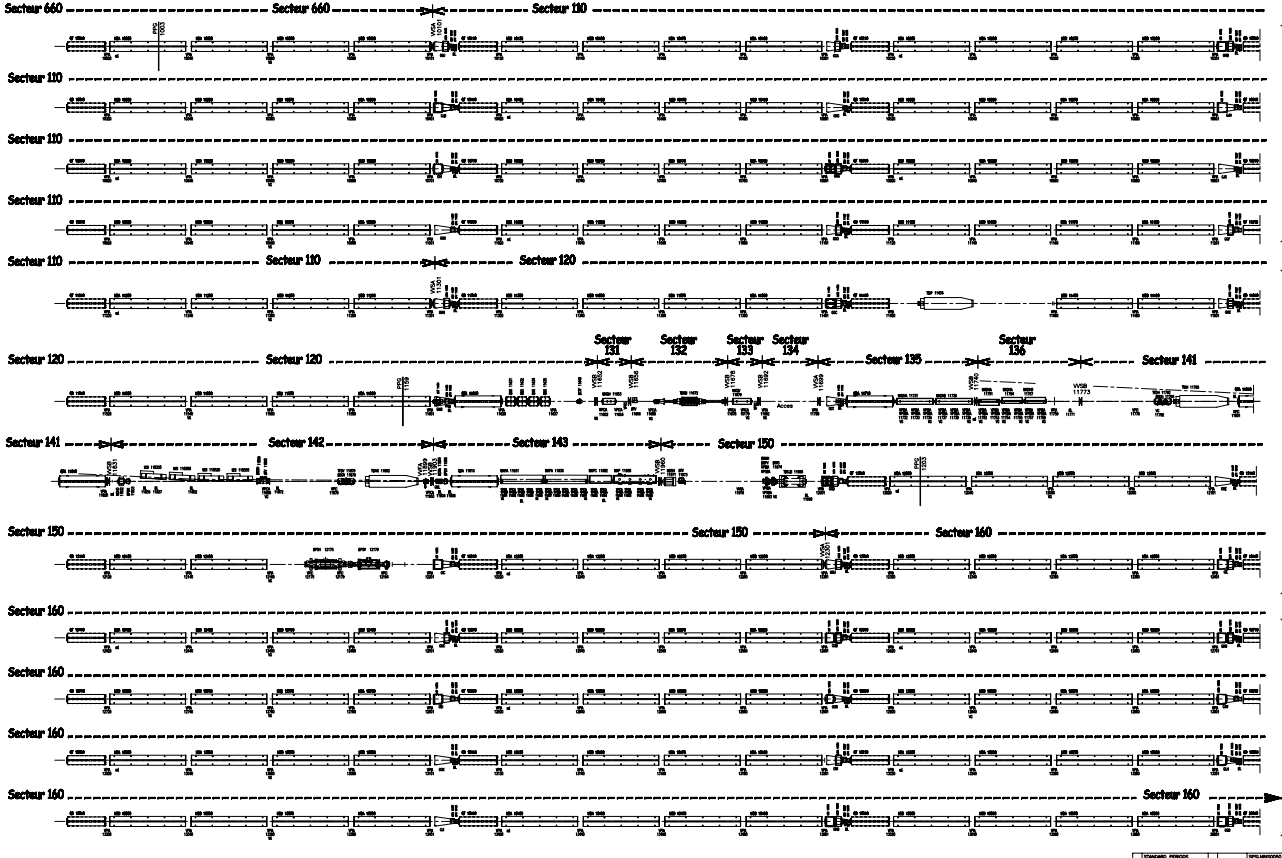

14	STANDARD PERIODS	3	SPSLNINS0050	
1	DETAILED LAYOUT	2	SPSLNINS0051	
1	LAYOUT SCHEMATIC	1	SPSLNINS0051	
REV	DESCRIPTION	PDG	MAT.	OBSERVATIONS	REF./DEPN

DRAWING		SLENG/FLASH	
LAYOUT D'INSTALLATION MACHINES LEP-SPS			
SPS – SEXTANT 1 LSS 1 SPS – SEXTANT 1 LSS-1		SCALE 1:100	DRAWN: L.NINSOLI 2009-02-21 CHECKED: J.BAUDON 2009-02-21 APPROVED: L.NINSOLI 2009-02-21 SPS\LNINS0\LNINS0049 MANUAL/REPORTS
PROJECT ENGINEER	AS BUILT		SPSLNINS0049

NO.	DATE	NOM/NAME	ZONE	MODIFICATION
